

PART 1 **ADDENDUM**

1.1 **TITLE**

- .1 This Addendum shall be known as:

 Addendum No. 5
 MUN-09 Feeder Cable Replacement & Pad Mount Switchgear
 TFM-048-25/TU-509-23

1.2 **PRECEDENCE**

- .1 This amendment to the bid documents is effective immediately.
- .2 This Addendum shall form an integral part of the original bid documents and is to be read in conjunction therewith.
- .3 The Addendum shall take precedence over previously issued bid documents with which it may prove to be at variance.

1.3 **GENERAL**

- .1 The General Conditions shall govern all phases of the Work covered by this Addendum.
- .2 Bidders are advised to acknowledge receipt of this addendum in their bid submission.

1.4 **CHANGES IN GENERAL**

- .1 Not used.

1.5 **CHANGES TO SPECIFICATIONS**

- .1 Reference Specification 26 13 20 – Pad Mounted SF6 Switchgear
 - .1 Add Clause 2.1.20 Standard of Acceptance: S&C Vista

1.6 **QUESTIONS**

- .1 **Question:** Request for approval of alternate switchgear – Schneider Premset series.
 - .1 **Answer:** The proposed alternate is compliant and suitable for approval as an equivalent to the specified S&C Vista switchgear for this project. Note that the contractor is responsible for any resulting design or installation modifications required as a result of the use of an alternate product. Specific to the proposed switchgear, for example, an external DC power source is required for this switchgear to operate. All supporting infrastructure for a complete operational system will be the responsibility of the contractor, including any design verification.

- .2 **Question:** Could you please clarify if 15KV aluminum TECK can be utilized in lieu of copper feeders identified in feeder schedule.

Spec: 2.2.3 Copper or aluminum circuit conductors, size and number as indicated on drawings.

Drawing indicates the usage of copper, will properly sized aluminum cables be acceptable?

- .1 **Answer:** Aluminum conductors of equivalent ampacity are acceptable.

END OF ADDENDUM NO. 5

PART 1 **ADDENDUM**

1.1 **TITLE**

- .1 This Addendum shall be known as:

 Addendum No. 4
 MUN-09 Feeder Cable Replacement & Pad Mount Switchgear
 TU-509-23

1.2 **PRECEDENCE**

- .1 This amendment to the bid documents is effective immediately.
- .2 This Addendum shall form an integral part of the original bid documents and is to be read in conjunction therewith.
- .3 The Addendum shall take precedence over previously issued bid documents with which it may prove to be at variance.

1.3 **GENERAL**

- .1 The General Conditions shall govern all phases of the Work covered by this Addendum.
- .2 Bidders are advised to acknowledge receipt of this addendum in their bid submission.

1.4 **CHANGES IN GENERAL**

- .1 New tender closing date: December 18, 2025 @ 3:30 PM. New access code is 2770 573 3674.

1.5 **CHANGES TO SPECIFICATIONS**

- .1 Reference Specification 26 05 14 – Power Cables 1001-15000V
 - .1 Update the storage location for the owner supplied cabling from South Campus Boiler Room to Engineering Building ground floor Mechanical Room EN1036.

1.6 **CHANGES TO DRAWINGS**


- .1 Reference Drawing E101 – Partial site plan, Demolition North - Revised
- .2 Reference Drawing E107 – Partial floor plan - Revised

- .3 Reference Drawing E601 - Partial Electrical Riser Diagram, Demolition - Revised
- .4 Reference Drawing E602 – Partial Electrical Riser Diagram – Revised
 - .1 Update Feeder Types 17 and 38 to indicate a 15kV rating.

1.7 QUESTIONS

- .1 **Question:** As per drawing E602, cable number 17, 17-T and 38, calls for a #3/0 copper grounding conductor. Is the #3/0 copper ground conductor required for each run of HV cable or, is one run of #3/0 ground conductor required for two runs of HV cable?
 - .1 **Answer:** One run of ground cable is required for the parallel runs of 15kV cabling.
- .2 **Question:** The specification calls for schedule 80 piping for bollards while the drawing states standard piping. Please confirm standard is acceptable.
 - .1 **Answer:** Standard Schedule 40 pipe is acceptable.
- .3 **Question:** The specification calls for schedule 80, 8" diameter bollards for the bolt-on type bollard, but the drawings show 6" piping. Please confirm 6" is acceptable.
 - .1 **Answer:** 6" is acceptable.
- .4 **Question:** The dimensions for the baseplates for the bolt-on type bollards are not defined on the drawings. Please confirm.
 - .1 **Answer:** Minimum baseplate dimension shall be 300mm x 300mm based on a 150mm bollard.
- .5 **Question:** The specification states bollards need to be galvanized and powder coated. To powder coat a galvanized bollard you would need to remove the galvanized coating. Please confirm powder coated is acceptable.
 - .1 **Answer:** Two layers of powder coat paint on standard steel is acceptable.

END OF ADDENDUM NO. 4

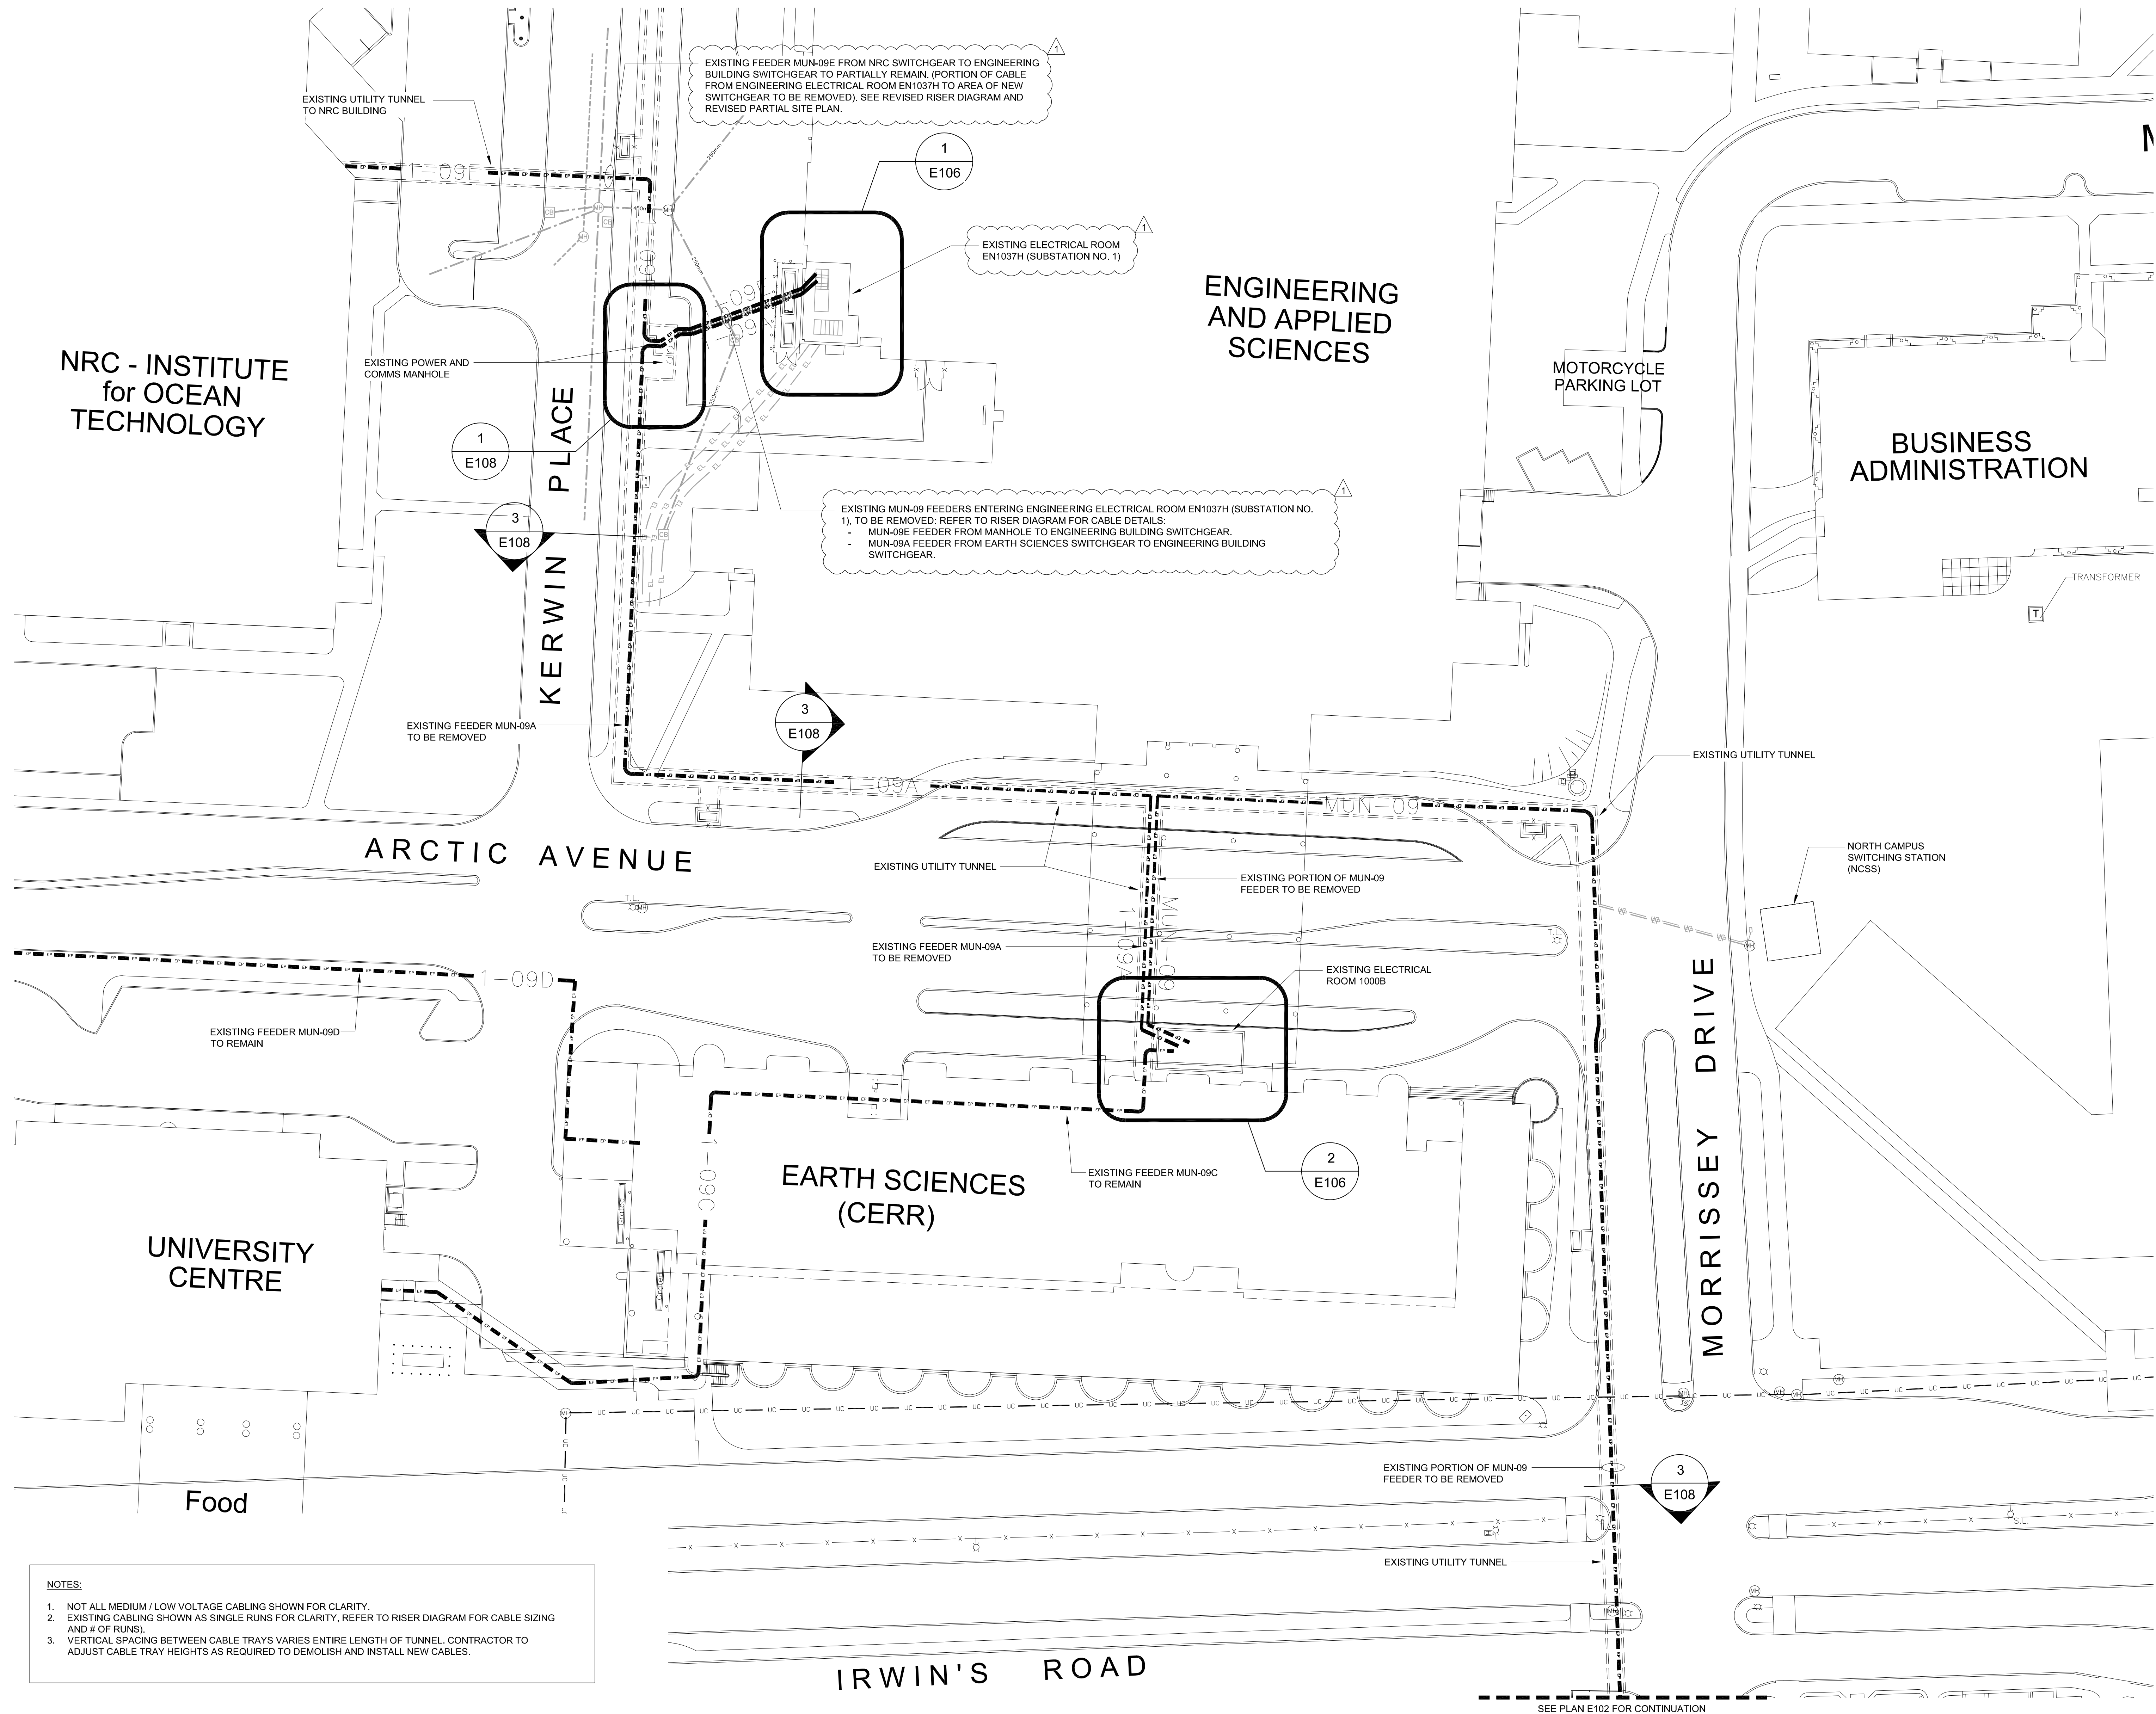

- NOTES:
1. NOT ALL MEDIUM / LOW VOLTAGE CABLING SHOWN FOR CLARITY.
 2. EXISTING CABLING SHOWN AS SINGLE RUNS FOR CLARITY, REFER TO RISER DIAGRAM FOR CABLE SIZING AND # OF RUNS.
 3. VERTICAL SPACING BETWEEN CABLE TRAYS VARIES ENTIRE LENGTH OF TUNNEL. CONTRACTOR TO ADJUST CABLE TRAY HEIGHTS AS REQUIRED TO DEMOLISH AND INSTALL NEW CABLES.

Revision

1 ISSUED FOR ADDENDUM
0 ISSUED FOR TENDER

Issued

File Name: E-101 Partial Site Plan - DEMO NORTH.dwg
Dwn. Chkd. Dgn. YY.MM.DD

Permit-Seal

Client/Project



Department of Facilities Management

MUN-09 FEEDER CABLE REPLACEMENT
& PAD MOUNT SWITCHGEAR
(TU-509-23)

St. John's, NL Canada

Title
PARTIAL SITE PLAN -
DEMOLITION NORTH

Project No. 133412009
Scale 1:350

Drawing No. E101
Revision




Copyright Reserved

The Contractor shall verify and be responsible for all dimensions. DO NOT scale the drawing - any errors or omissions shall be reported to Stantec without delay.

The Copyrights to all designs and drawings are the property of Stantec. Reproduction or use for any purpose other than that authorized by Stantec is forbidden.

Legend

otes

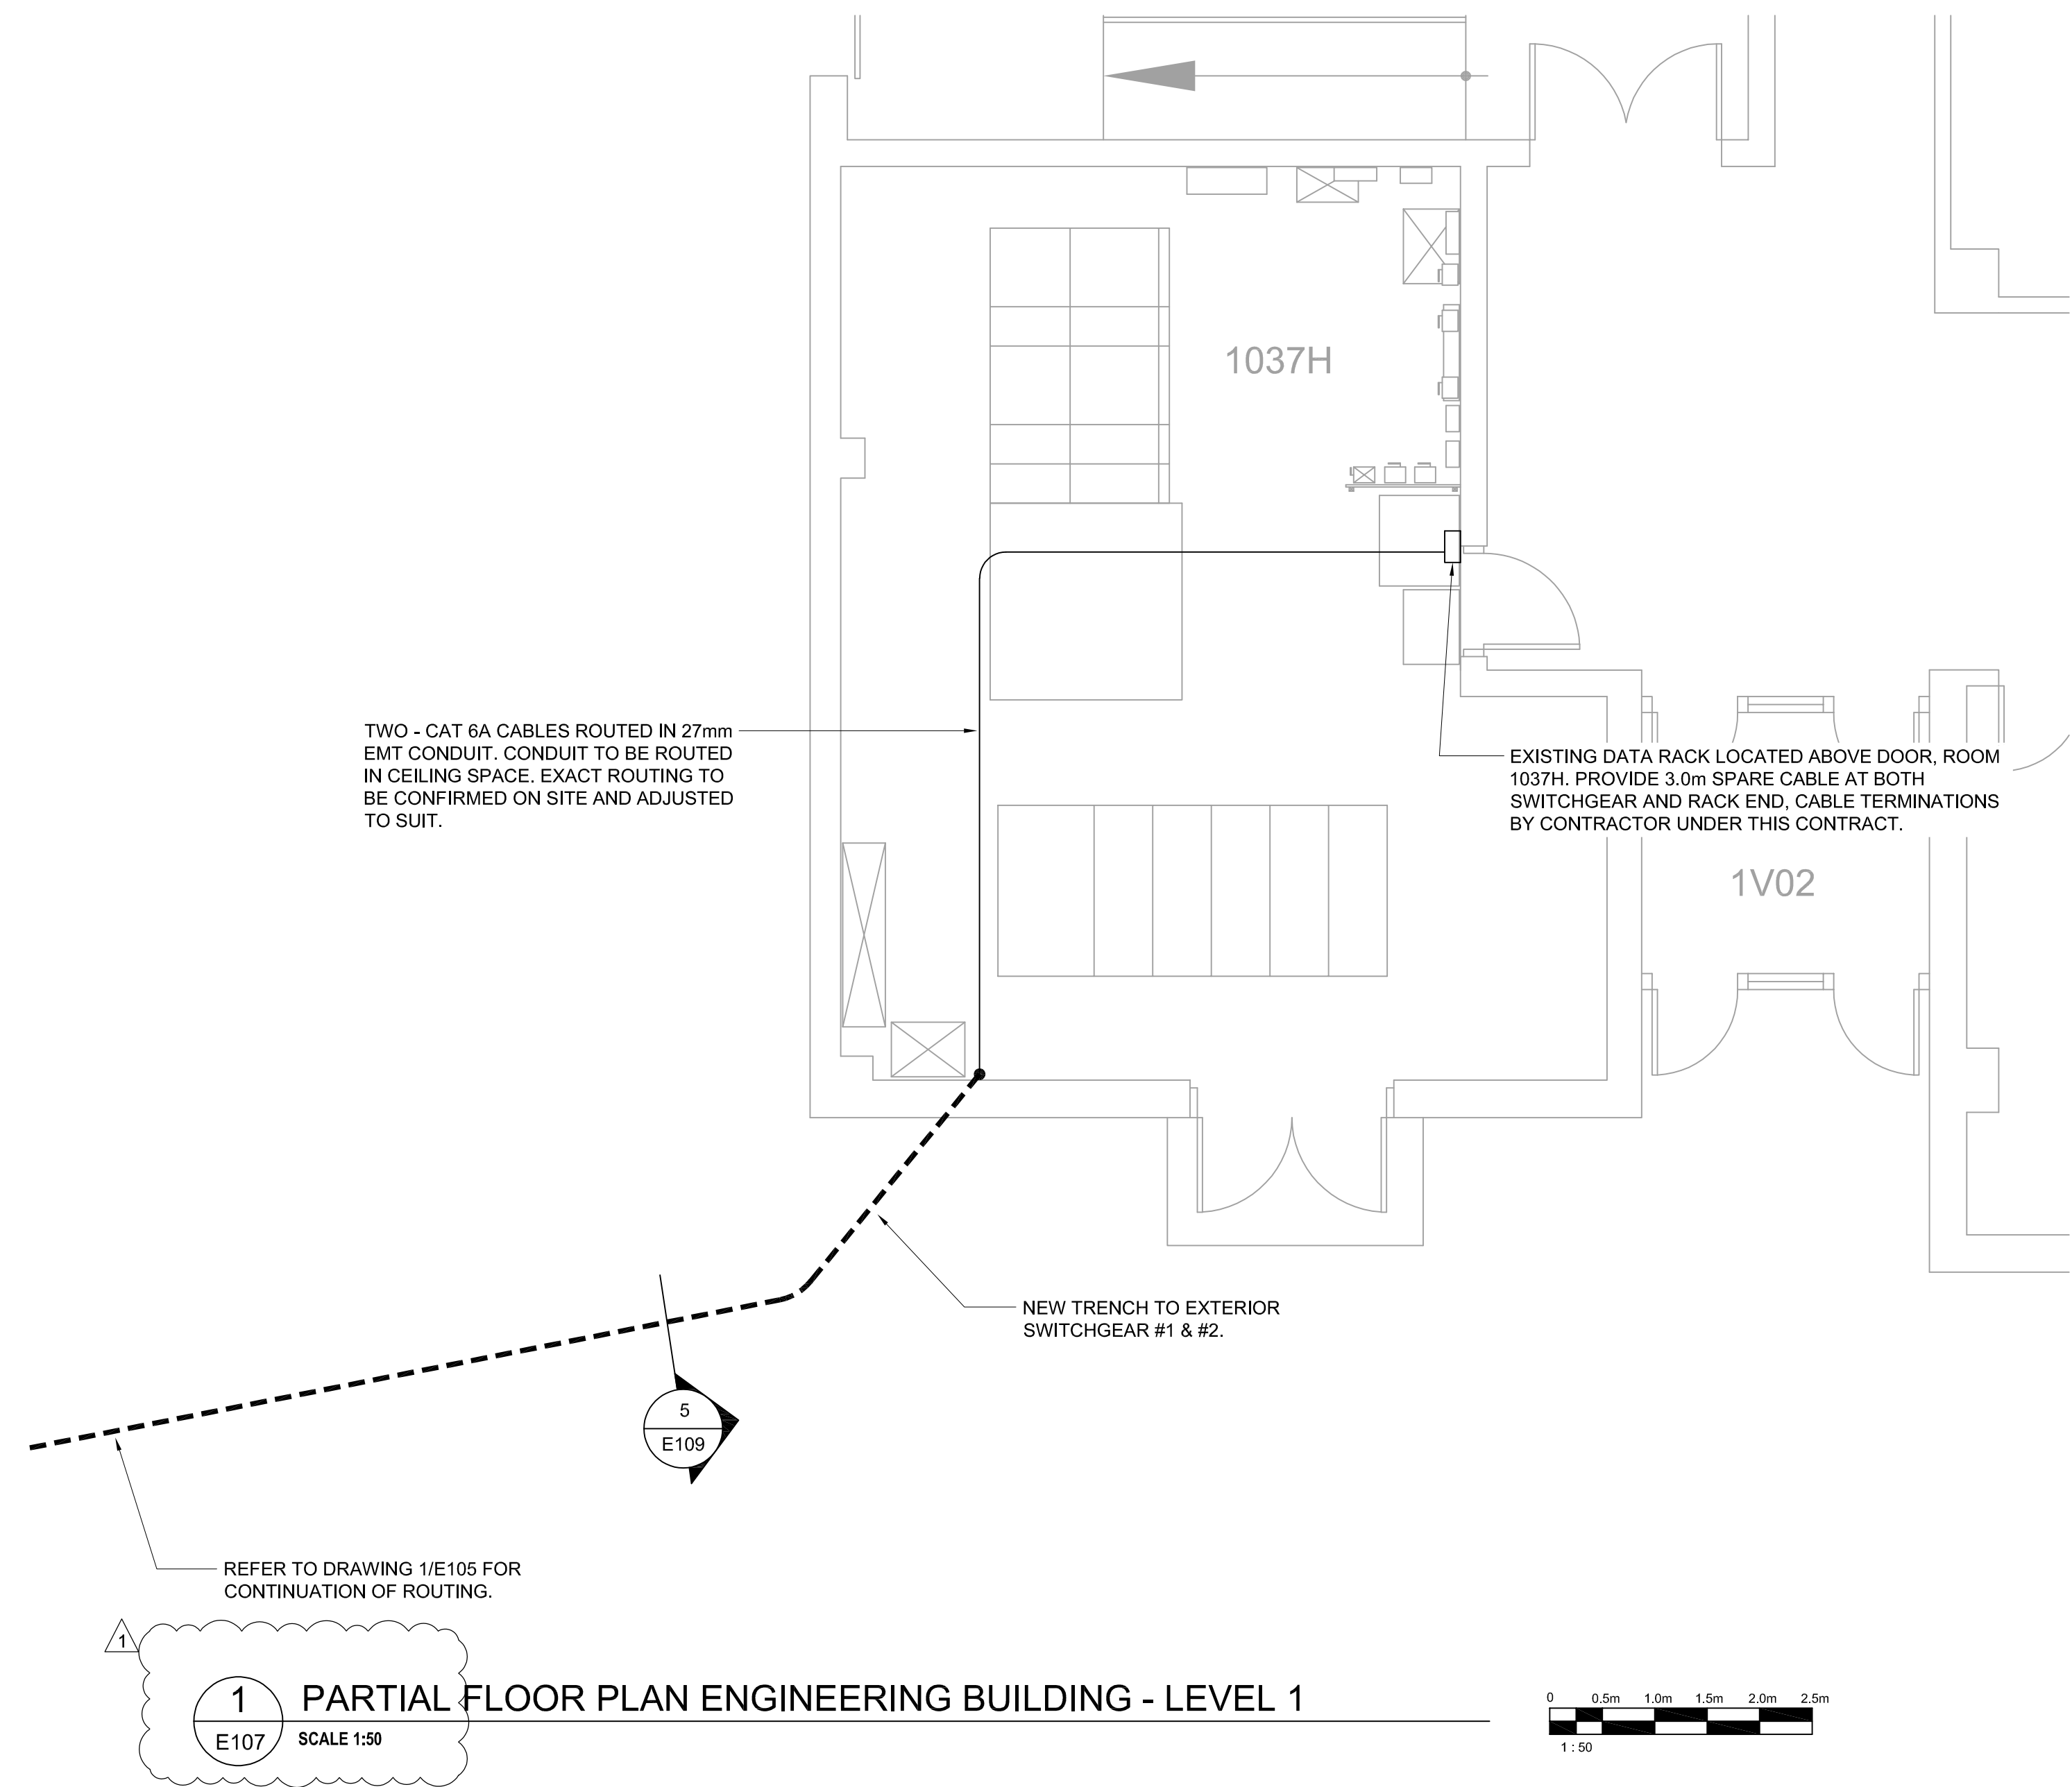[illegible]

Permit-Seal

Client/Project



Department of Facilities Management

MUN-09 FEEDER CABLE REPLACEMENT
& PAD MOUNT SWITCHGEAR
(TU-509-23)

St. John's, NL Canada

PARTIAL FLOOR PLAN

Project No.

scale

AS SHOWN

Drawing No.

revision

E107



The Contractor shall verify and be responsible for all dimensions. DO NOT scale the drawing - any errors or omissions shall be reported to Stantec without delay.
The Copyrights to all designs and drawings are the property of Stantec. Reproduction or use for any purpose other than that authorized by Stantec is forbidden.

otes

NOTES:

1. EXISTING INDICATORS EXISTING TO REMAIN UNLESS OTHERWISE INDICATED.
2. SHADING SPARE // RUNS OF TECK CABLE ROUTED IN TUNNEL CABLE TRAY, TO REMAIN FOR FUTURE USE.
3. EXISTING // RUNS OF TECK CABLE ROUTED IN TUNNEL//FROM DEADENDS IN MANHOLE-MH-18-SB-TO EARTH SCIENCES MAIN ELECTRICAL ROOM TO BE REMOVED.
4. EXISTING POWER FEED FROM ENGINEERING BUILDING TO EXISTING BUILDING TO BE PARTIALLY REMOVED. DISCONNECT CABLE FROM ENGINEERING BUILDING SWITCHGEAR PULSES BULKY THROUGH USE OF SWITCHGEAR TO EXISTING POWER ADJACENT TO BUILDING. CABLES FOR CONNECTION NEW EXTERIOR SWITCHGEAR, REFER TO REVERSED RISER. PORTION OF CABLE FROM EXISTING POWER MANHOLE TO NRC SWITCHGEAR TO REMAIN IN PLACE.
5. EXISTING POWER FEED FROM EARTH SCIENCES SWITCHGEAR TO ENGINEERING BUILDING SWITCHGEAR TO BE REMOVED.



Revision	By	Appd.	YY.MM.DD
ISSUED FOR ADDENDUM	JD	BR	25.12.08
ISSUED FOR TENDER	JD	BR	25.10.23
Issued	By	Appd.	YY.MM.DD
File Name: E-601 Particl Riser - DEMO_R1.dwg			
	Dwn.	Chkd.	Dsgn.
			YY.MM.DD

Permit-Seal

Client/Project



St. John's, NL Canada

PARTIAL ELECTRICAL RISER
DIAGRAM - DEMOLITION

Project No.	Scale
133412009	N.T.S.

Drawing No. _____ Revision _____

E601

1



The Contractor shall verify and be responsible for all dimensions. DO NOT scale the drawing - any errors or omissions shall be reported to Stantec without delay.
The Copyrights to all designs and drawings are the property of Stantec. Reproduction or use for any purpose other than that authorized by Stantec is forbidden.


otes

NOTES:

1. SHADING INDICATES EXISTING TO REMAIN UNLESS OTHERWISE INDICATED.
2. NEW POWER FEED FROM MANHOLE WHS-EL-08 TO NEW EXTERIOR SWITCHGEAR, CABLES SUPPLIED AND INSTALLED BY CONTRACTOR UNDER THIS CONTRACT. CABLES ROUTED IN EXISTING CABLE TRAY IN TUNNEL.
3. NEW POWER FEED ROUTED FROM EXTERIOR SWITCHGEAR TO ENGINEERING BUILDING SUBSTATION, CABLES SUPPLIED BY MUN AND INSTALLED BY CONTRACTOR UNDER THIS CONTRACT. CABLES ROUTED IN EXISTING U/G CONDUITS.
4. EXISTING POWER FEED PULLED FROM ENGINEERING BUILDING TO NEW EXTERIOR SWITCHGEAR AND TERMINATED UNDER THIS CONTRACT. EXISTING PORTION OF CABLE FROM NEW EXTERIOR SWITCHGEAR TO NRC ELECTRICAL ROOM IS EXISTING TO REMAIN.
5. NEW POWER FEED FROM EXTERIOR SWITCHGEAR TO EARTH SCIENCES BUILDING, CABLES SUPPLIED AND INSTALLED BY CONTRACTOR UNDER THIS CONTRACT. CABLES ROUTED IN EXISTING CABLE TRAY IN TUNNEL AND U/G CONDUITS.
6. NEW MUN-09 CABLE TO BE SPICED (MAXIMUM TWO SPICES IN CABLE RUN). SEE REVISION SITE PLAN FOR APPROXIMATE LOCATIONS. CABLE SPICES TO BE LOCATED SO OVERALL CABLE RUN = 3 EQUAL LENGTHS. ADJUST LOCATIONS AS REQUIRED.
7. NEW POWER FEED BETWEEN EXTERIOR SWITCHGEAR #1 & #2, CABLES SUPPLIED BY MUN AND INSTALLED BY CONTRACTOR UNDER THIS CONTRACT.
8. EXISTING SPARE 2 RUNS OF 3 NO. 500kcmil 15kV NU-AL TECK CABLE ROUTED IN TUNNEL CABLE TRAY (FOR FUTURE USE).



Permit-Seal



MEMORIAL
UNIVERSITY

PARTIAL ELECTRICAL RISER
DIAGRAM - REVISED

Project No.	Scale
133412009	N.T.S.
Drawing No.	Revision