PART 1 - ADDENDUM

1.1 TITLE

.1 This Addendum shall be known as:

Addendum 2
TFM-044-25

.2 The Date of the Addendum is Friday, October 31, 2025

1.2 PRECEDENCE

a

.1 This amendment to the bid documents is effective immediately.

.2 This Addendum shall form an integral part of the original bid documents and is to be read in conjunction therewith.

.3 The Addendum shall take precedence over previously issued bid documents with which it may prove to be at variance.

1.3 GENERAL

.1 The General Conditions shall govern all phases of the Work covered by this Addendum.

.2 Acknowledge receipt of this addendum in the Tender and Acceptance form.

1.4 PURPOSE

.1 The purpose of the Addendum is to inform bidders of the changes, deletions and additions to be added to the bid documents.

1.5 CHANGES IN GENERAL

.1 Ceiling types are generally acoustic tile, some areas have gypsum bulkheads with portions of tile. Refer to attached drawing markup. <<3451 – Mun Bruneau Centre level 1 & 2 Ceiling types markup.pdf>>

CHANGES TO SPECIFICATION

1. Specification section 23 31.13.01 Metal Ducts
    1. Add attached Specification Section 23 31 13.01 METAL DUCT – LOW PRESSURE TO 500PA.

1.6 CHANGES TO DRAWINGS

.1 Add the following general note. “Remove and reinstate ceiling as required to accommodate the work.” To the following drawings:
    .1 M-1.1 - LEVEL 1 FLOOR PLAN - NEW HYDRONIC PIPING LAYOUT
    .2 M-1.2 - LEVEL 2 FLOOR PLAN - NEW HYDRONIC PIPING LAYOUT

.3 M-2.1 - LEVEL 1 FLOOR PLAN - NEW VENTILATION LAYOUT
.4 M-2.2 - LEVEL 2 FLOOR PLAN - NEW VENTILATION LAYOUT
.5 M-3.1 - LEVEL 1 FLOOR PLAN - NEW CONTROLS LAYOUT
.6 M-3.2 - LEVEL 2 FLOOR PLAN - NEW CONTROLS LAYOUT

END OF ADDENDUM

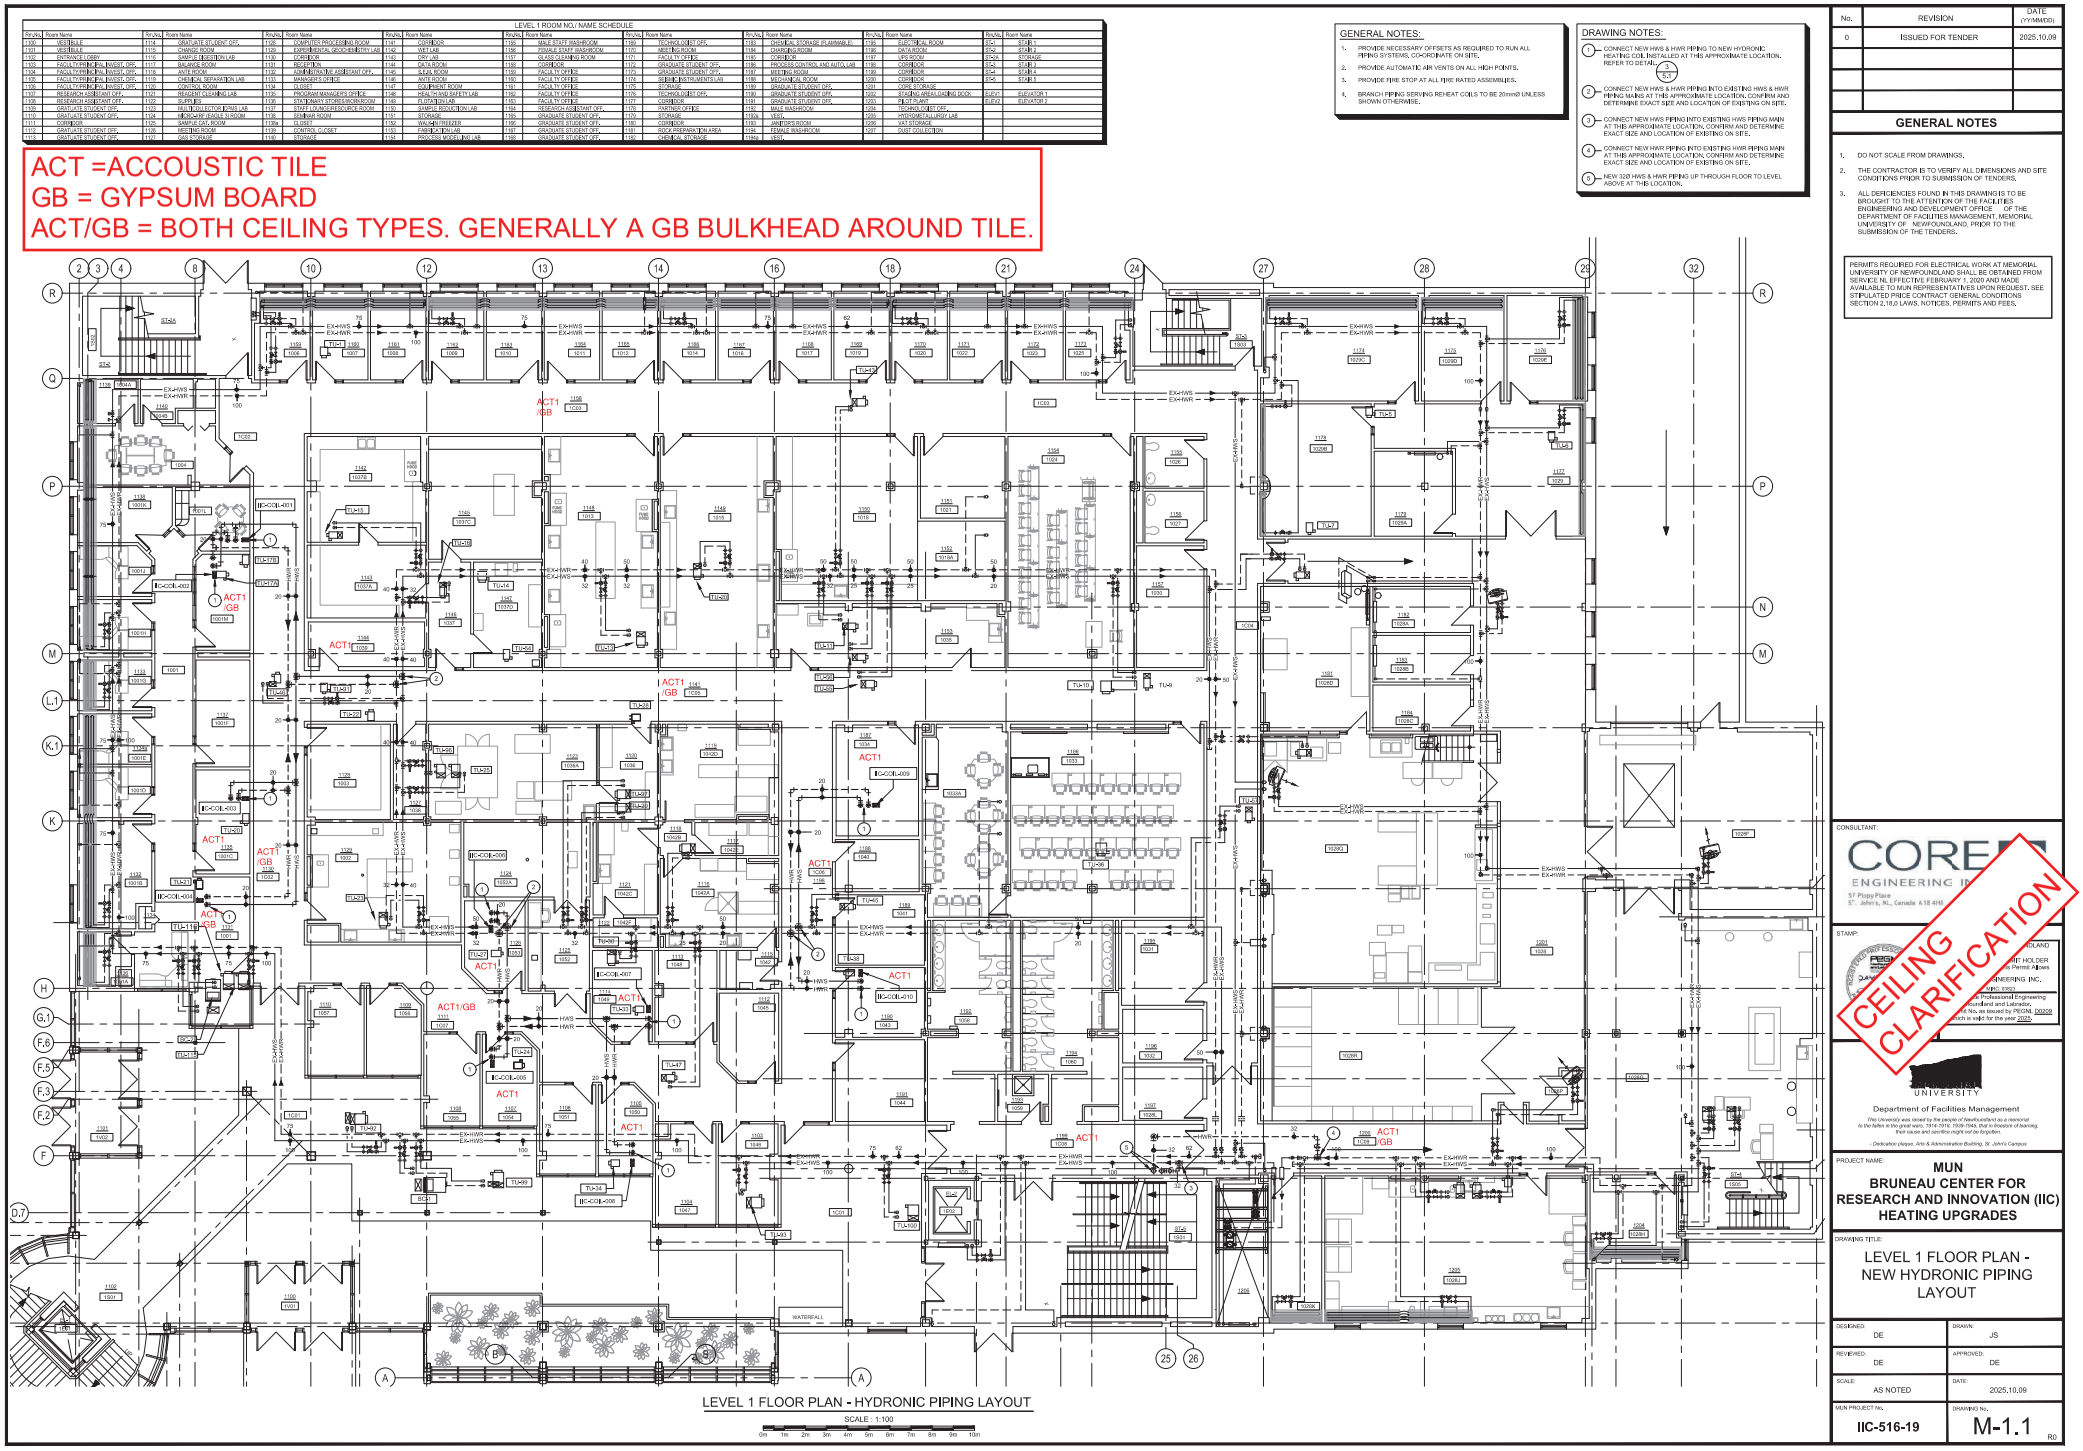

No.	REVISION	DATE (YY/MM/DD)
0	ISSUED FOR TENDER	2025.10.09

GENERAL NOTES

1. DO NOT SCALE FROM DRAWINGS.
2. THE CONTRACTOR IS TO VERIFY ALL DIMENSIONS AND SITE CONDITIONS PRIOR TO SUBMISSION OF TENDERS.
3. ALL DEFICIENCIES FOUND IN THIS DRAWING IS TO BE BROUGHT TO THE ATTENTION OF THE FACILITIES ENGINEERING AND DEVELOPMENT OFFICE OF THE DEPARTMENT OF FACILITIES MANAGEMENT, MEMORIAL UNIVERSITY OF NEWFOUNDLAND, PRIOR TO THE SUBMISSION OF THE TENDERS.

PERMITS REQUIRED FOR ELECTRICAL WORK AT MEMORIAL UNIVERSITY OF NEWFOUNDLAND SHALL BE OBTAINED FROM SERVICE NL EFFECTIVE FEBRUARY 1, 2020 AND MADE AVAILABLE TO MUN REPRESENTATIVES UPON REQUEST. SEE STIPULATED PRICE CONTRACT GENERAL CONDITIONS SECTION 2.18.0 LAWS, NOTICES, PERMITS AND FEES.

CONSULTANT:
CORE ENGINEERING INC.
57 Pippy Place
St. John's, NL, Canada A1B 4H8

CEILING CLARIFICATION

STAMP:

Department of Facilities Management

This University was raised by the people of Newfoundland as a memorial to the fallen in the great wars, 1914-1918, 1939-1945, that in theatres of learning their cause and sacrifice might not be forgotten.
- Dedication plaque, Arts & Administration Building, St. John's Campus

PROJECT NAME:
MUN BRUNEAU CENTER FOR RESEARCH AND INNOVATION (IIC) HEATING UPGRADES

DRAWING TITLE:
LEVEL 1 FLOOR PLAN - NEW HYDRONIC PIPING LAYOUT

DESIGNED: DE	DRAWN: JS
REVIEWED: DE	APPROVED: DE
SCALE: AS NOTED	DATE: 2025.10.09
MUN PROJECT No.: IIC-516-19	DRAWING No.: M-1.1 R0

LEVEL 2 ROOM NO./ NAME SCHEDULE

Rm.No.	Room Name	Rm.No.	Room Name	Rm.No.	Room Name	Rm.No.	Room Name	Rm.No.	Room Name
2100	MEZZANINE	2114	SKUNKWORKS	2128	CLOSET	2140	OFFICE	2154	CORRIDOR
2101	LECTURE THEATRE	2115	CORD'S OFF.	2129	MEETING ROOM	2141	OFFICE	2155	ENGINEERING COMPUTER LAB
2102	CORRIDOR	2116	OFFICE	2130	BOARD ROOM	2142	STORAGE/PHOTOCOPIER	2156	ANTE ROOM
2103	BREAKOUT AREA	2117	OFFICE	2131	WAITING AREA	2143	RECEPTION		
2104	KITCHENETTE	2118	DEAN'S OFFICE	2132	DATA ROOM	2144	MEETING ROOM	ST1	STAIR 1
2105	COAT ROOM	2119	2 SECRETARY OFF.	2133	MALE WASHROOM	2145	RESEARCH GENERAL OFF.	ST2	STAIR 2
2106	SKUNKWORKS (ABOR. CHAIR TEMP.)	2120	ASSOCIATE DEAN'S OFF.	2133a	VEST.	2146	ASSOCIATE DIRECTOR'S OFF.	ST3	STAIR 3
2107	SKUNKWORKS	2121	2 PERSON OFF.	2134	JANITOR'S ROOM	2147	OFFICE	ST4	STAIR 4
2108	LINK	2122	GRAD STUDENT GENERAL OFF.	2135	ELECTRICAL ROOM	2148	OFFICE	ST5	STAIR 5
2109	CORRIDOR	2123	OFFICE	2136	FEMALE WASHROOM	2149	DIRECTOR'S OFF.		
2110	CORRIDOR	2124	2 PERSON OFF.	2136a	VEST.	2150	CLOSET	ELEV1	ELEVATOR 1
2111	SKUNKWORKS	2125	RECEPTION	2137	CORRIDOR	2151	OFFICE	ELEV2	ELEVATOR 2
2112	SKUNKWORKS	2126	STORAGE	2138	OFFICE	2152	OFFICE		
2113	CORRIDOR	2127	STAFF LOUNGE	2139	OFFICE	2153	OFFICE		

ACT =ACCOUSTIC TILE
GB = GYPSUM BOARD
ACT/GB = BOTH CEILING TYPES. GENERALLY A GB BULKHEAD AROUND TILE.

GENERAL NOTES:

1. PROVIDE NECESSARY OFFSETS AS REQUIRED TO RUN ALL PIPING SYSTEMS. CO-ORDINATE ON SITE.
2. PROVIDE AUTOMATIC AIR VENTS ON ALL HIGH POINTS.
3. PROVIDE FIRE STOP AT ALL FIRE RATED ASSEMBLIES.
4. BRANCH PIPING SERVING REHEAT COILS TO BE 20mmØ UNLESS SHOWN OTHERWISE.

DRAWING NOTES:

(1) CONNECT NEW HWS & HWR PIPING TO NEW HYDRONIC HEATING COIL INSTALLED AT THIS APPROXIMATE LOCATION. REFER TO DETAIL 3/5.1
(2) NEW HWS & HWR PIPING UP THROUGH FLOOR FROM LEVEL BELOW AT THIS LOCATION. REFER TO DETAIL 5/5.1
(3) NEW CIRCUIT SETTER BALANCING VALVE. SET AT 0.47 L/s

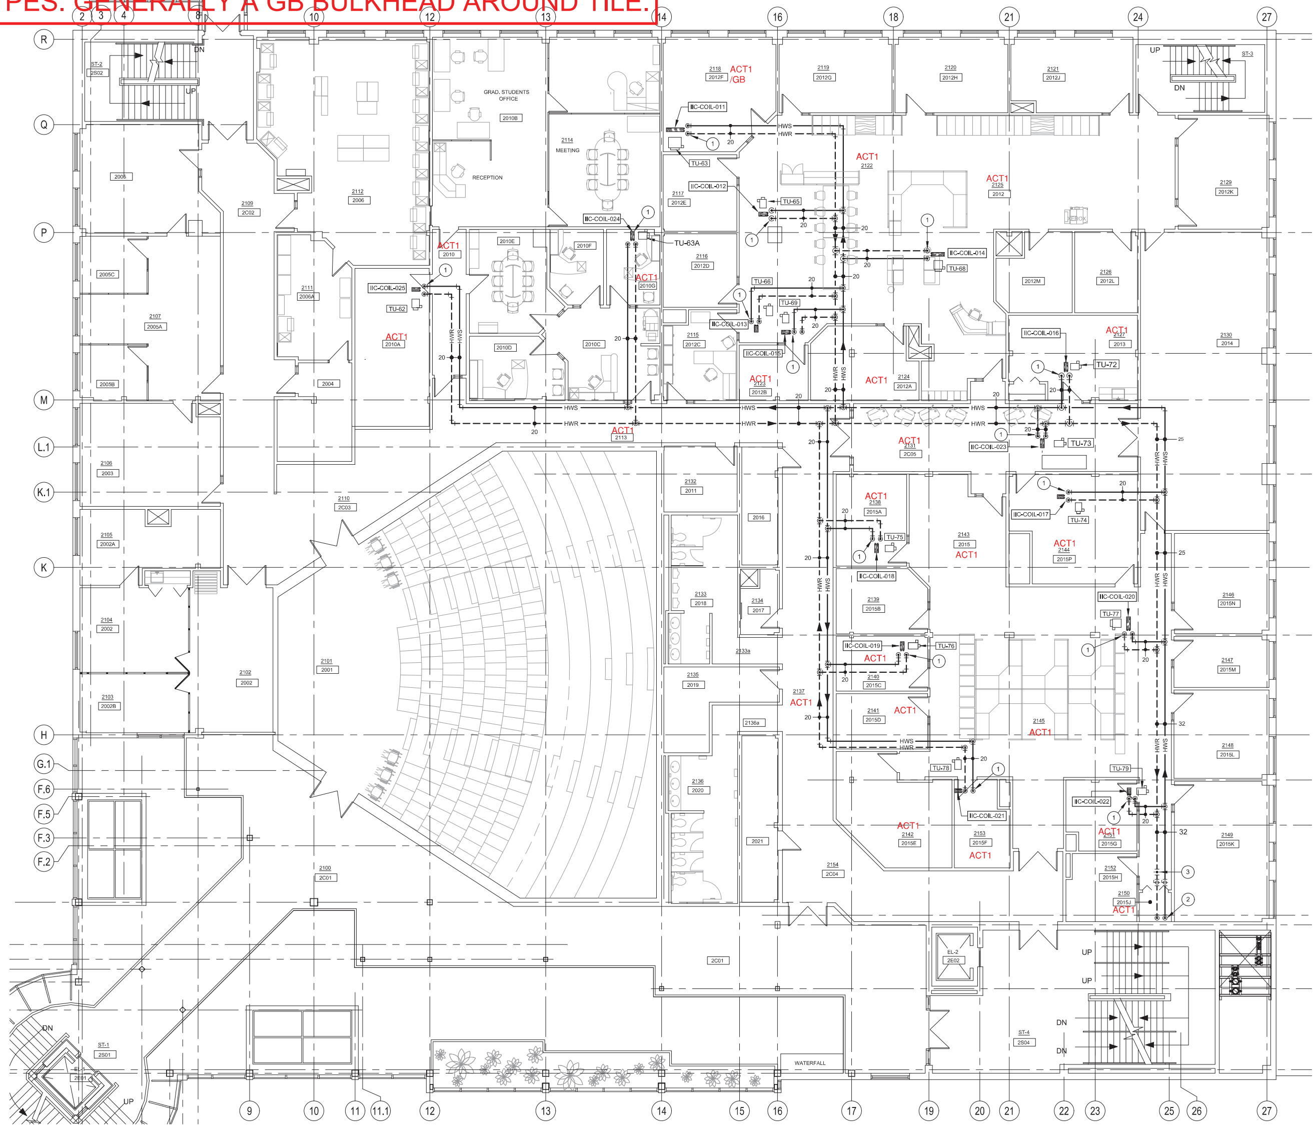

LEVEL 2 FLOOR PLAN - HYDRONIC PIPING LAYOUT

SCALE : 1:100

No.	REVISION	DATE (YY/MM/DD)
0	ISSUED FOR TENDER	2025,10,09

GENERAL NOTES

1. DO NOT SCALE FROM DRAWINGS.
2. THE CONTRACTOR IS TO VERIFY ALL DIMENSIONS AND SITE CONDITIONS PRIOR TO SUBMISSION OF TENDERS.
3. ALL DEFICIENCIES FOUND IN THIS DRAWING IS TO BE BROUGHT TO THE ATTENTION OF THE FACILITIES ENGINEERING AND DEVELOPMENT OFFICE OF THE DEPARTMENT OF FACILITIES MANAGEMENT, MEMORIAL UNIVERSITY OF NEWFOUNDLAND, PRIOR TO THE SUBMISSION OF THE TENDERS.

PERMITS REQUIRED FOR ELECTRICAL WORK AT MEMORIAL UNIVERSITY OF NEWFOUNDLAND SHALL BE OBTAINED FROM SERVICE NL EFFECTIVE FEBRUARY 1, 2020 AND MADE AVAILABLE TO MUN REPRESENTATIVES UPON REQUEST. SEE STIPULATED PRICE CONTRACT GENERAL CONDITIONS SECTION 2.18.0 LAWS, NOTICES, PERMITS AND FEES.

CONSULTANT:

CORE ENGINEERING INC.
57 Pippy Place
St. John's, NL, Canada A1B 4H8

STAMP:

CEILING CLARIFICATION

MEMORIAL UNIVERSITY

Department of Facilities Management

This University was raised by the people of Newfoundland as a memorial to the fallen in the great wars, 1914-1918, 1939-1945, that in freedom of learning, their cause and sacrifice might not be forgotten.

- Dedication plaque, Arts & Administration Building, St. John's Campus

PROJECT NAME:

MUN BRUNEAU CENTER FOR RESEARCH AND INNOVATION (IIC) HEATING UPGRADES

DRAWING TITLE:

LEVEL 2 FLOOR PLAN - NEW HYDRONIC PIPING LAYOUT

DESIGNED:	DE	DRAWN:	JS
REVIEWED:	DE	APPROVED:	DE
SCALE:	AS NOTED	DATE:	2025,10,09
MUN PROJECT No.	IIC-516-19	DRAWING No.	M-1.2

R0

LEVEL 1 ROOM NO./ NAME SCHEDULE

Rm.No.	Room Name	Rm.No.	Room Name	Rm.No.	Room Name	Rm.No.	Room Name	Rm.No.	Room Name	Rm.No.	Room Name	Rm.No.	Room Name	Rm.No.	Room Name	Rm.No.	Room Name
1100	VESTIBULE	1114	GRATUATE STUDENT OFF.	1128	COMPUTER PROCESSING ROOM	1141	CORRIDOR	1155	MALE STAFF WASHROOM	1169	TECHNOLOGIST OFF.	1183	CHEMICAL STORAGE (FLAMMABLE)	1195	ELECTRICAL ROOM	ST-1	STAIR 1
1101	VESTIBULE	1115	CHANGE ROOM	1129	EXPERIMENTAL GEOCHEMISTRY LAB	1142	WET LAB	1156	FEMALE STAFF WASHROOM	1170	MEETING ROOM	1184	CHARGING ROOM	1196	DATA ROOM	ST-2	STAIR 2
1102	ENTRANCE LOBBY	1116	SAMPLE DIGESTION LAB	1130	CORRIDOR	1143	DRY LAB	1157	GLASS CLEANING ROOM	1171	FACULTY OFFICE	1185	CORRIDOR	1197	UPS ROOM	ST-2A	STORAGE
1103	FACULTY/PRINCIPAL INVEST. OFF.	1117	BALANCE ROOM	1131	RECEPTION	1144	DATA ROOM	1158	CORRIDOR	1172	GRADUATE STUDENT OFF.	1186	PROCESS CONTROL AND AUTO. LAB	1198	CORRIDOR	ST-3	STAIR 3
1104	FACULTY/PRINCIPAL INVEST. OFF.	1118	ANTE ROOM	1132	ADMINISTRATIVE ASSISTANT OFF.	1145	S.E.M. ROOM	1159	FACULTY OFFICE	1173	GRADUATE STUDENT OFF.	1187	MEETING ROOM	1199	CORRIDOR	ST-4	STAIR 4
1105	FACULTY/PRINCIPAL INVEST. OFF.	1119	CHEMICAL SEPARATION LAB	1133	MANAGER'S OFFICE	1146	ANTE ROOM	1160	FACULTY OFFICE	1174	SEISMIC INSTRUMENTS LAB	1188	MECHANICAL ROOM	1200	CORRIDOR	ST-5	STAIR 5
1106	FACULTY/PRINCIPAL INVEST. OFF.	1120	CONTROL ROOM	1134	CLOSET	1147	EQUIPMENT ROOM	1161	FACULTY OFFICE	1175	STORAGE	1189	GRADUATE STUDENT OFF.	1201	CORE STORAGE		
1107	RESEARCH ASSISTANT OFF.	1121	REAGENT CLEANING LAB	1135	PROGRAM MANAGER'S OFFICE	1148	HEALTH AND SAFETY LAB	1162	FACULTY OFFICE	1176	TECHNOLOGIST OFF.	1190	GRADUATE STUDENT OFF.	1202	STAGING AREA/LOADING DOCK	ELEV1	ELEVATOR 1
1108	RESEARCH ASSISTANT OFF.	1122	SUPPLIES	1136	STATIONARY STORES/WORKROOM	1149	FLOTATION LAB	1163	FACULTY OFFICE	1177	CORRIDOR	1191	GRADUATE STUDENT OFF.	1203	PILOT PLANT	ELEV2	ELEVATOR 2
1109	GRATUATE STUDENT OFF.	1123	MULTICOLLECTOR ICPMS LAB	1137	STAFF LOUNGE/RESOURCE ROOM	1150	SAMPLE REDUCTION LAB	1164	RESEARCH ASSISTANT OFF.	1178	PARTNER OFFICE	1192	MALE WASHROOM	1204	TECHNOLOGIST OFF.		
1110	GRATUATE STUDENT OFF.	1124	MICRO-XRF (EAGLE 3) ROOM	1138	SEMINAR ROOM	1151	STORAGE	1165	GRADUATE STUDENT OFF.	1179	STORAGE	1192a	VEST.	1205	HYDROMETALLURGY LAB		
1111	CORRIDOR	1125	SAMPLE CAT. ROOM	1138a	CLOSET	1152	WALK-IN FREEZER	1166	GRADUATE STUDENT OFF.	1180	CORRIDOR	1193	JANITOR'S ROOM	1206	VAT STORAGE		
1112	GRATUATE STUDENT OFF.	1126	MEETING ROOM	1139	CONTROL CLOSET	1153	FABRICATION LAB	1167	GRADUATE STUDENT OFF.	1181	ROCK PREPARATION AREA	1194	FEMALE WASHROOM	1207	DUST COLLECTION		
1113	GRATUATE STUDENT OFF.	1127	GAS STORAGE	1140	STORAGE	1154	PROCESS MODELLING LAB	1168	GRADUATE STUDENT OFF.	1182	CHEMICAL STORAGE	1194a	VEST.				

ACT =ACCOUSTIC TILE
GB = GYPSUM BOARD
ACT/GB = BOTH CEILING TYPES. GENERALLY A GB BULKHEAD AROUND TILE.

GENERAL NOTES:

1. PROVIDE PLENUMS/TRANSITIONS TO CONNECT DUCT TO GRILLE.
2. COORDINATE ALL DUCT ROUTING TO AVOID INTERFERENCES. RE-ROUTE AS REQUIRED.
3. PROVIDE BALANCING DAMPERS ON ALL SUB-BRANCH DUCTS, LOCATE BALANCING DAMPERS AT CONNECTION TO MAIN DUCT.
4. PROVIDE OFFSETS TO AVOID STRUCTURAL BEAMS, PIPING, OTHER DUCT, ETC. WHERE REQUIRED.

DRAWING NOTES:

(1) INSTALL NEW HYDRONIC HEATING COIL IN EXISTING SUPPLY AIR DUCT. PROVIDE TRANSITIONS AS REQUIRED. PROVIDE NEW THERMAL INSULATION ON NEW DUCT/TRANSITIONS. CONFIRM EXACT DUCT SIZE AND LOCATION ON SITE. REFER TO DETAIL. 3/5.1

(2) EXISTING SUPPLY AIR DUCT TO BE REMOVED TO ALLOW FOR INSTALLATION OF NEW.

(3) CONNECT NEW SUPPLY AIR DUCT TO EXISTING IN THIS APPROXIMATE LOCATION. CONFIRM EXACT LOCATION ON SITE.

(4) EXISTING TERMINAL UNIT TO REMAIN (TYPICAL). CONTROLS AND BALANCING CONTRACTOR TO WORK TOGETHER TO VERIFY THE CALIBRATION AND MINIMUM/MAXIMUM FLOWS ON EXISTING TERMINAL UNITS. REFER TO SCHEDULE.

(5) RE-BALANCE EXISTING SUPPLY AIR GRILLE TO AIR FLOWS INDICATED (TYPICAL)

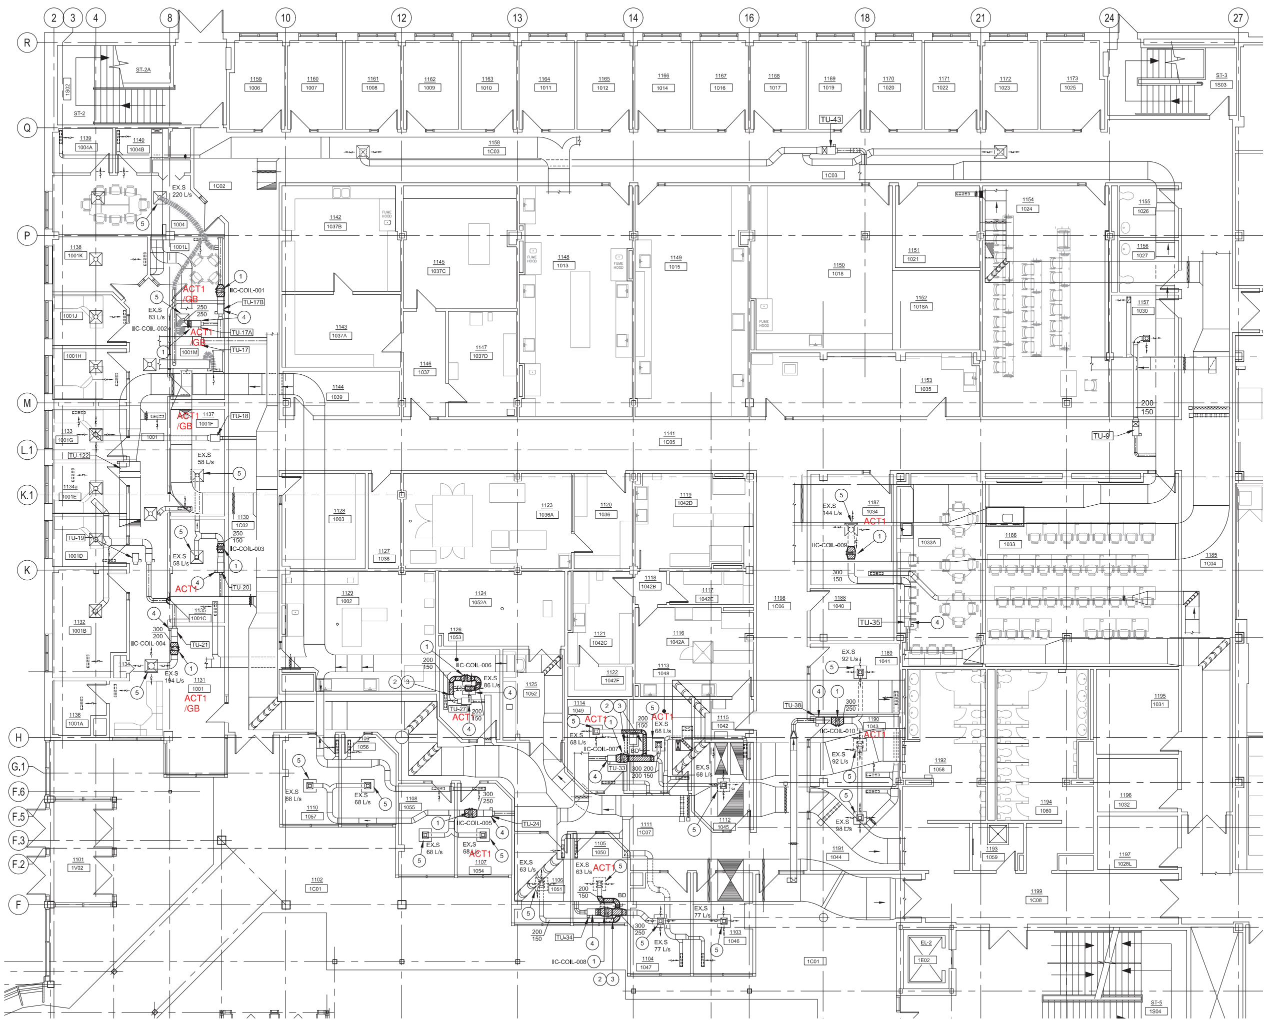

LEVEL 1 FLOOR PLAN - VENTILATION LAYOUT

SCALE : 1:100

No.	REVISION	DATE (YY/MM/DD)
0	ISSUED FOR TENDER	2025.10.09

GENERAL NOTES

1. DO NOT SCALE FROM DRAWINGS.
2. THE CONTRACTOR IS TO VERIFY ALL DIMENSIONS AND SITE CONDITIONS PRIOR TO SUBMISSION OF TENDERS.
3. ALL DEFICIENCIES FOUND IN THIS DRAWING IS TO BE BROUGHT TO THE ATTENTION OF THE FACILITIES ENGINEERING AND DEVELOPMENT OFFICE OF THE DEPARTMENT OF FACILITIES MANAGEMENT, MEMORIAL UNIVERSITY OF NEWFOUNDLAND, PRIOR TO THE SUBMISSION OF THE TENDERS.

PERMITS REQUIRED FOR ELECTRICAL WORK AT MEMORIAL UNIVERSITY OF NEWFOUNDLAND SHALL BE OBTAINED FROM SERVICE NL EFFECTIVE FEBRUARY 1, 2020 AND MADE AVAILABLE TO MUN REPRESENTATIVES UPON REQUEST. SEE STIPULATED PRICE CONTRACT GENERAL CONDITIONS SECTION 2.18.0 LAWS, NOTICES, PERMITS AND FEES.

CONSULTANT:
CORE ENGINEERING INC.
57 Pippy Place
St. John's, NL, Canada A1B 4H8

CEILING CLARIFICATION

STAMP:

MEMORIAL UNIVERSITY
Department of Facilities Management

PROJECT NAME:
MUN
BRUNEAU CENTER FOR RESEARCH AND INNOVATION (IIC) HEATING UPGRADES

DRAWING TITLE:
LEVEL 1 FLOOR PLAN - NEW VENTILATION LAYOUT

DESIGNED: DE	DRAWN: JS
REVIEWED: DE	APPROVED: DE
SCALE: AS NOTED	DATE: 2025.10.09
MUN PROJECT No.: IIC-516-19	DRAWING No.: M-2.1

R0

LEVEL 2 ROOM NO./ NAME SCHEDULE

Rm.No.	Room Name	Rm.No.	Room Name	Rm.No.	Room Name	Rm.No.	Room Name	Rm.No.	Room Name
2100	MEZZANINE	2114	SKUNKWORKS	2128	CLOSET	2140	OFFICE	2154	CORRIDOR
2101	LECTURE THEATRE	2115	CORD'S OFF.	2129	MEETING ROOM	2141	OFFICE	2155	ENGINEERING COMPUTER LAB
2102	CORRIDOR	2116	OFFICE	2130	BOARD ROOM	2142	STORAGE/PHOTOCOPIER	2156	ANTE ROOM
2103	BREAKOUT AREA	2117	OFFICE	2131	WAITING AREA	2143	RECEPTION		
2104	KITCHENETTE	2118	DEAN'S OFFICE	2132	DATA ROOM	2144	MEETING ROOM	ST1	STAIR 1
2105	COAT ROOM	2119	2 SECRETARY OFF.	2133	MALE WASHROOM	2145	RESEARCH GENERAL OFF.	ST2	STAIR 2
2106	SKUNKWORKS (ABOR. CHAIR TEMP.)	2120	ASSOCIATE DEAN'S OFF.	2133a	VEST.	2146	ASSOCIATE DIRECTOR'S OFF.	ST3	STAIR 3
2107	SKUNKWORKS	2121	2 PERSON OFF.	2134	JANITOR'S ROOM	2147	OFFICE	ST4	STAIR 4
2108	LINK	2122	GRAD STUDENT GENERAL OFF.	2135	ELECTRICAL ROOM	2148	OFFICE	ST5	STAIR 5
2109	CORRIDOR	2123	OFFICE	2136	FEMALE WASHROOM	2149	DIRECTOR'S OFF.		
2110	CORRIDOR	2124	2 PERSON OFF.	2136a	VEST.	2150	CLOSET	ELEV1	ELEVATOR 1
2111	SKUNKWORKS	2125	RECEPTION	2137	CORRIDOR	2151	OFFICE	ELEV2	ELEVATOR 2
2112	SKUNKWORKS	2126	STORAGE	2138	OFFICE	2152	OFFICE		
2113	CORRIDOR	2127	STAFF LOUNGE	2139	OFFICE	2153	OFFICE		

ACT =ACCOUSTIC TILE
GB = GYPSUM BOARD
ACT/GB = BOTH CEILING TYPES. GENERALLY A GB BULKHEAD AROUND TILE.

GENERAL NOTES:

1. PROVIDE PLENUMS/TRANSITIONS TO CONNECT DUCT TO GRILLE.
2. COORDINATE ALL DUCT ROUTING TO AVOID INTERFERENCES. RE-ROUTE AS REQUIRED.
3. PROVIDE BALANCING DAMPERS ON ALL SUB-BRANCH DUCTS. LOCATE BALANCING DAMPERS AT CONNECTION TO MAIN DUCT.
4. PROVIDE OFFSETS TO AVOID STRUCTURAL BEAMS, PIPING, OTHER DUCT, ETC. WHERE REQUIRED.

DRAWING NOTES:

(1) INSTALL NEW HYDRONIC HEATING COIL IN EXISTING SUPPLY AIR DUCT. PROVIDE TRANSITIONS AS REQUIRED. PROVIDE NEW THERMAL INSULATION ON NEW DUCT/TRANSITIONS. CONFIRM EXACT DUCT SIZE AND LOCATION ON SITE, REFER TO DETAIL 3/5.1

(2) EXISTING SUPPLY AIR DUCT TO BE REMOVED TO ALLOW FOR INSTALLATION OF NEW.

(3) CONNECT NEW SUPPLY AIR DUCT TO EXISTING IN THIS APPROXIMATE LOCATION. CONFIRM EXACT LOCATION ON SITE.

(4) EXISTING TERMINAL UNIT TO REMAIN (TYPICAL). CONTROLS AND BALANCING CONTRACTOR TO WORK TOGETHER TO VERIFY THE CALIBRATION AND MINIMUM/MAXIMUM FLOWS ON EXISTING TERMINAL UNITS

(5) RE-BALANCE EXISTING SUPPLY AIR GRILLE TO VALUES INDICATED (TYPICAL)

(6) EXISTING DIFFUSER AIRFLOW TO BE MEASURED PRIOR TO CONSTRUCTION. SET TO PRE-CONSTRUCTION AIR FLOWS.

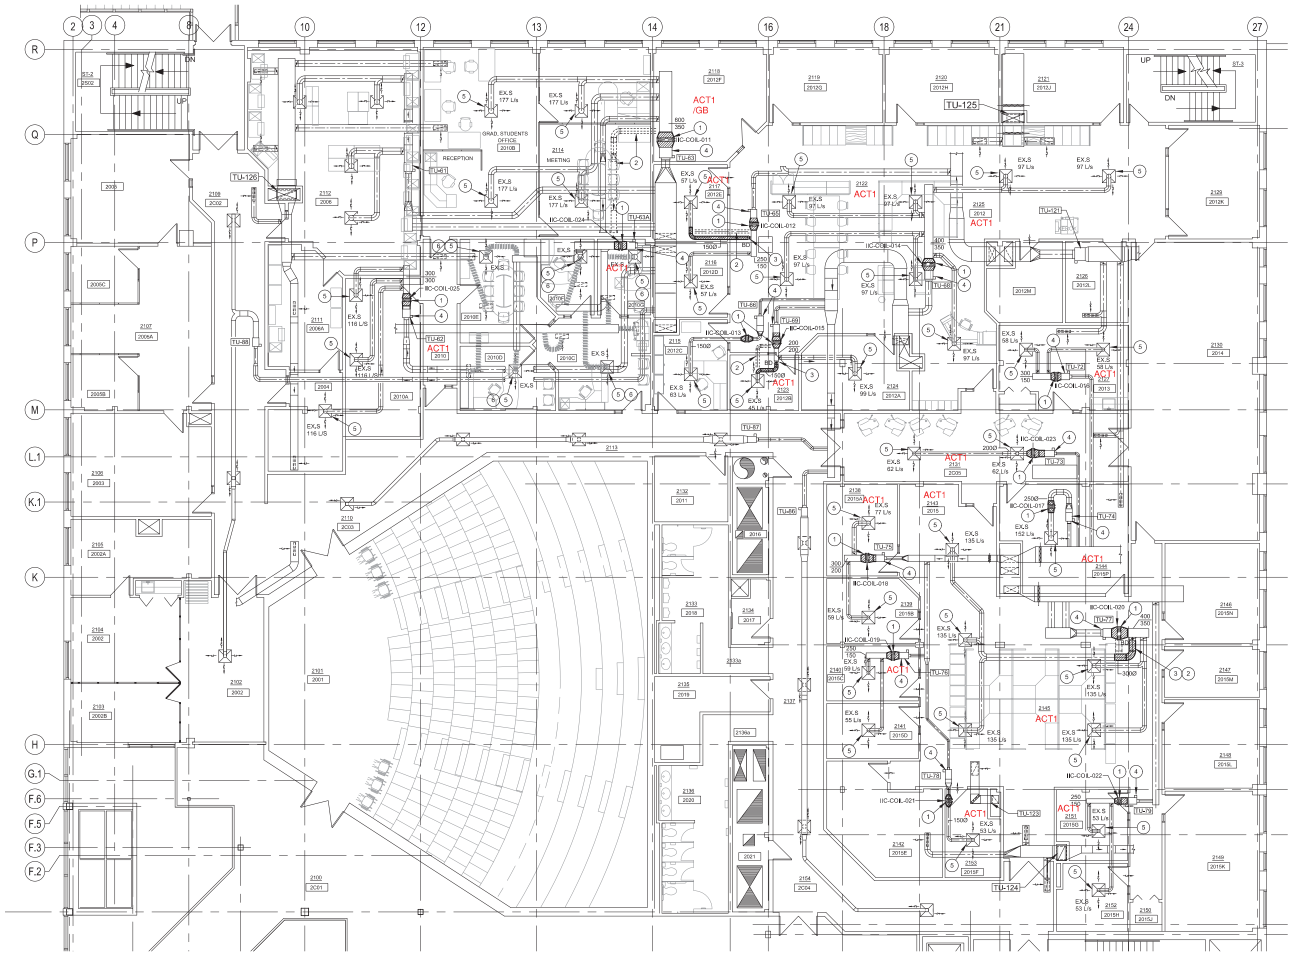

LEVEL 2 FLOOR PLAN - VENTILATION LAYOUT

SCALE : 1:100

0m 1m 2m 3m 4m 5m 6m 7m 8m 9m 10m

No.	REVISION	DATE (YY/MM/DD)
0	ISSUED FOR TENDER	2025.10.09

GENERAL NOTES

1. DO NOT SCALE FROM DRAWINGS.
2. THE CONTRACTOR IS TO VERIFY ALL DIMENSIONS AND SITE CONDITIONS PRIOR TO SUBMISSION OF TENDERS.
3. ALL DEFICIENCIES FOUND IN THIS DRAWING IS TO BE BROUGHT TO THE ATTENTION OF THE FACILITIES ENGINEERING AND DEVELOPMENT OFFICE OF THE DEPARTMENT OF FACILITIES MANAGEMENT, MEMORIAL UNIVERSITY OF NEWFOUNDLAND, PRIOR TO THE SUBMISSION OF THE TENDERS.

PERMITS REQUIRED FOR ELECTRICAL WORK AT MEMORIAL UNIVERSITY OF NEWFOUNDLAND SHALL BE OBTAINED FROM SERVICE NL EFFECTIVE FEBRUARY 1, 2020 AND MADE AVAILABLE TO MUN REPRESENTATIVES UPON REQUEST. SEE STIPULATED PRICE CONTRACT GENERAL CONDITIONS SECTION 2.18.0 LAWS, NOTICES, PERMITS AND FEES.

CONSULTANT:

CORE ENGINEERING INC.
57 Pippy Place
St. John's, NL, Canada A1B 4H8

STAMP:

CEILING CLARIFICATION

...NDLAND
...MIT HOLDER
...is Permit Allows
...GINEERING INC.
...MIRC: 03823
...e Professional Engineering
...oundland and Labrador.
...mit No. as issued by PEGNL D0209
...hich is valid for the year 2025.

MEMORIAL UNIVERSITY

Department of Facilities Management

This University was raised by the people of Newfoundland as a memorial to the fallen in the great wars, 1914-1918, 1939-1945, that in freedom of learning, their cause and sacrifice might not be forgotten.

- Dedication plaque, Arts & Administration Building, St. John's Campus

PROJECT NAME:

MUN BRUNEAU CENTER FOR RESEARCH AND INNOVATION (IIC) HEATING UPGRADES

DRAWING TITLE:

LEVEL 2 FLOOR PLAN - NEW VENTILATION LAYOUT

DESIGNED:	DE	DRAWN:	JS
REVIEWED:	DE	APPROVED:	DE
SCALE:	AS NOTED	DATE:	2025.10.09
MUN PROJECT No.	IIC-516-19	DRAWING No.	M-2.2

R0

PART 1 GENERAL

1.1 SUMMARY

.1 Section includes:

.1 Materials and installation of low-pressure metallic ductwork, joints and accessories.

1.2 RELATED SECTIONS

.1 Section 01 33 00 – Submittal Procedures.

.2 Section 01 35 29.06 – Health and Safety Requirements

.3 Section 01 74 21 – Construction/Demolition Waste Management and Disposal.

.4 Section 01 91 13.13 – Commissioning (Cx) Requirements.

.5 Section 07 84 00 – Firestopping

.6 Section 23 05 29 – Hangers and Supports for HVAC Piping and Equipment.

.7 Section 23 05 94 – Pressure Testing of Ducted Air Systems.

.8 Section 23 40 00 – HVAC Air Filtration

1.3 REFERENCES

.1 American Society of Heating, Refrigerating and Air-Conditioning Engineers, Inc. (ASHRAE).

.2 American Society for Testing and Materials International, (ASTM).

.1 ASTM A 480/A480M, Standard Specification for General Requirements for Flat-Rolled Stainless and Heat-Resisting Steel Plate, Sheet and Strip.

.2 ASTM A635/A635M, Standard Specification for Steel, Sheet and Strip, Heavy-Thickness Coils, Hot-Rolled, Alloy, Carbon, Structural, High-Strength Low-Alloy, and High-Strength Low-Alloy with Improved Formability, General Requirements for.

.3 ASTM A 653/A653M, Standard Specification for Steel Sheet, Zinc Coated (Galvanized) or Zinc-Iron Alloy Coated (Galvannealed) by the Hot-Dip Process.

.3 Department of Justice Canada (Jus).

.1 Canadian Environmental Protection Act (CEPA).

.4 Health Canada/Workplace Hazardous Materials Information System (WHMIS).

.1 Safety Data Sheets (SDS).

.5 National Fire Protection Association (NFPA).

.1 NFPA 90A, Standard for the Installation of Air-Conditioning and Ventilating Systems.

.2 NFPA 90B, Standard for the Installation of Warm Air Heating and Air-Conditioning Systems.

.3 NFPA 96, Standard for Ventilation Control and Fire Protection of Commercial Cooking Operations.

.6 Sheet Metal and Air Conditioning Contractors' National Association (SMACNA).

.1 SMACNA HVAC Duct Construction Standards - Metal and Flexible.

.2 SMACNA HVAC Air Duct Leakage Test Manual.

.3 IAQ Guideline for Occupied Buildings Under Construction, 1st Edition.

.7 Transport Canada (TC).

.1 Transportation of Dangerous Goods Act (TDGA).

1.4 SUBMITTALS

.1 Submit shop drawings and product data in accordance with Section 01 33 00 - Submittal Procedures.

.2 Product Data: submit WHMIS SDS - Safety Data for the following:

.1 Sealants.

.2 Tape.

.3 Proprietary Joints.

1.5 QUALITY ASSURANCE

.1 Certification of Ratings:

.1 Catalogue or published ratings shall be those obtained from tests carried out by manufacturer or independent testing agency signifying adherence to codes and standards.

.2 Health and Safety:

.1 Do construction occupational health and safety in accordance with Section 01 35 29.06 - Health and Safety Requirements.

.2 During construction meet or exceed the requirements of SMACNA IAQ Guideline for Occupied Buildings under Construction.

.3 Installers to be certified to journeyperson level in sheet metal work.

1.6 DELIVERY, STORAGE AND HANDLING

.1 Protect on site stored or installed absorptive material from moisture damage.

.2 Waste Management and Disposal:

.1 Separate waste materials for reuse and recycling in accordance with Section 01 74 21 - Construction/Demolition Waste Management and Disposal.

.2 Remove from site and dispose of packaging materials at appropriate recycling facilities.

.3 Collect and separate for disposal, paper, plastic, polystyrene, corrugated cardboard, packaging material in appropriate on-site bins for recycling in accordance with Waste Management Plan.

.4 Separate for reuse and recycling and place in designated containers steel, metal, plastic waste in accordance with Waste Management Plan.

.5 Place materials defined as hazardous or toxic in designated containers.

.6 Handle and dispose of hazardous materials in accordance with CEPA, TDGA, Regional and Municipal regulations.

.7 Fold up metal and plastic banding, flatten and place in designated area for recycling.

PART 2 PRODUCTS

2.1 SEAL CLASSIFICATION

.1 Classification as follows:

Maximum Pressure Pa	SMACNA Seal Class
> 1000	A
750	B
500	C
250	C
125	C

.2 Seal classification:

.1 Class A: longitudinal seams, transverse joints, duct wall penetrations and connections made airtight with sealant and tape.

2.2 SEALANT

.1 Sealant: oil resistant, polymer type flame resistant duct sealant. Temperature range of minus 30°C to plus 93°C.

2.3 TAPE

.1 Tape: polyvinyl treated, open weave fiberglass tape, 50 mm wide.

2.4 DUCT LEAKAGE

.1 In accordance with SMACNA HVAC Duct Leakage Test Manual.

2.5 FITTINGS

.1 Fabrication: to SMACNA.

.2 Radiused elbows:

.1 Rectangular: Centreline radius: 1.5 times width of duct.

.2 Round: smooth radius or five piece. Centreline radius: 1.5 times diameter.

.3 Mitred elbows, rectangular:

.1 To 400 mm: with single thickness turning vanes.

.2 Over 400 mm: with double thickness turning vanes.

.4 Branches:

.1 Rectangular main and branch: with radius on branch 1.5 times width of duct or 45^0 entry on branch.

.2 Round main and branch: enter main duct at 45^0 with conical connection.

.3 Provide volume control damper in branch duct near connection to main duct.

.4 Main duct branches: with volume control damper.

.5 Transitions:

.1 Diverging: 20^0 maximum included angle.

.2 Converging: 30^0 maximum included angle.

.6 Offsets:

.1 Full short radiused elbows as indicated.

.7 Obstruction deflectors: maintain full cross-sectional area. Maximum included angles: as for transitions.

2.6 FIRESTOPPING

.1 Retaining angles around duct, on both sides of fire separation in accordance with Section 07 84 00 – Firestopping.

.2 Firestopping material and installation must not distort duct.

2.7 GALVANIZED STEEL

.1 Lock forming quality: to ASTM A653, G90 zinc coating.

.2 Thickness, fabrication and reinforcement: to SMACNA.

.3 Joints: to SMACNA or proprietary manufactured duct joint. Proprietary manufactured flanged duct joint to be considered to be a class A seal.

2.8 HANGERS AND SUPPORTS

.1 Strap hangers: of same material as duct but next sheet metal thickness heavier than duct. Maximum size duct supported by strap hanger: 500 mm.

.2 Hanger configuration: to SMACNA.

.3 Hangers: galvanized steel angle with black steel rods to ASHRAE or SMACNA following table:

Duct Size (mm)	Angle Size (mm)	Rod Size (mm)
up to 750	25x25x3	6
751 to 1050	40x40x3	6
1051 to 1500	40x40x3	10
1501 to 2100	50x50x3	10
2101 to 2400	50x50x5	10
2401 and over	50 x 50 x 6	10

.4 Upper hanger attachments:

.1 For concrete: manufactured concrete inserts.

.2 For steel joist: manufactured joist clamp steel plate washer.

.3 For steel beams: manufactured beam clamps:

PART 3 EXECUTION

3.1 GENERAL

.1 Do work in accordance with SMACNA.

.2 Do not break continuity of insulation vapour barrier with hangers or rods. Insulate strap hangers 100 mm beyond insulated duct.

.3 Support risers in accordance with SMACNA.

.4 Install breakaway joints in ductwork on sides of fire separation. Do not place fire stopping material in expansion space between damper sleeve and fire partition.

.5 Install proprietary manufactured flanged duct joints in accordance with manufacturer's instructions.

.6 Manufacture duct in lengths and diameter to accommodate installation of acoustic duct lining.

3.2 HANGERS

.1 Strap hangers: install in accordance with SMACNA.

.2 Angle hangers: complete with locking nuts and washers.

.3 Hanger spacing: in accordance with SMACNA or as follows:

Duct Size (mm)	Spacing (mm)
to 1500	3000
1501 and over	2500

3.3 SEALING AND TAPING

.1 Apply sealant to outside of joint to manufacturer's recommendations.

.2 Bed tape in sealant and recoat with minimum of one coat of sealant to manufacturers recommendations. Sealant and tape to be applied to full perimeter of duct.

3.4 LEAKAGE TESTS/COMMISSIONING

.1 Seal ducting and call for review prior to insulating. Re seal areas noted by Engineer or Owners representative.

END OF SECTION

PART 1 - ADDENDUM

1.1 TITLE

.1 This Addendum shall be known as:

Addendum 1
TFM-044-25

.2 The Date of the Addendum is Tuesday, October 22, 2025

1.2 PRECEDENCE

a

.1 This amendment to the bid documents is effective immediately.

.2 This Addendum shall form an integral part of the original bid documents and is to be read in conjunction therewith.

.3 The Addendum shall take precedence over previously issued bid documents with which it may prove to be at variance.

1.3 GENERAL

.1 The General Conditions shall govern all phases of the Work covered by this Addendum.

.2 Acknowledge receipt of this addendum in the Tender and Acceptance form.

1.4 PURPOSE

.1 The purpose of the Addendum is to inform bidders of the changes, deletions and additions to be added to the bid documents.

1.5 CHANGES IN GENERAL

.1 No changes in General.

CHANGES TO SPECIFICATION

1. Specification section 01 21 00 ALLOWANCE
    1. Replace 1.1.1 as follows:

    1.1.1 Include in Contract Price, cash allowances as stated herein:.

    .1 $50,000.00 Cash allowance for Honeywell Controls

1.6 CHANGES TO DRAWINGS

.1 No changes to drawing.

END OF ADDENDUM

PART 1- GENERAL

1.1 CASH ALLOWANCES

.1 Include in Contract Price, cash allowances as stated herein:

- $50,000.00 Cash allowance for Honeywell Controls.

.2 Expend each allowance as directed by Owner.

.3 Cash allowances, unless otherwise specified, cover net cost to Contractor of services, products, construction machinery and equipment, freight, handling, unloading, storage installation and other authorized expenses incurred in performing Work.

.4 Each cash allowance will be adjusted to actual cost as defined hereunder and contract price will be amended accordingly by written order.

.5 Contract Price will be adjusted by written order to provide for an excess or deficit to each cash allowance.

.6 Progress payments for work and material authorized under cash allowances will be made in accordance with contract terms of payment.

.7 The Contract Price and not cash allowance, includes contractor's overhead and profit in connection with such cash allowance.

.8 Progress payments on accounts of work authorized under cash allowances shall be included in monthly certificate for payment.

.9 Schedule shall be prepared jointly by Owner and Contractor to show when items called for under cash allowances must be authorized by Owner for ordering purposes so that progress of work will not be delayed.

PART 2PRODUCTS (NOT APPLICABLE)

PART 3EXECUTION (NOT APPLICABLE)

END OF SECTION